


GREAT SPACE AVAILABLE

IN NEWLY RENOVATED BUILDING

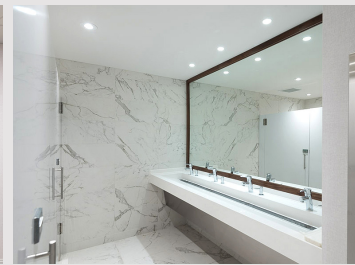

1825 K STREET, NW

WASHINGTON, DC 20006

SPACE AVAILABLE

5th Floor	– 9,167 RSF
5th Floor	– 2,647 RSF
5th Floor	– 2,349 RSF
5th Floor	– 2,199 RSF
6th Floor	– 13,200 RSF
7th Floor	– 1,628 RSF
7th Floor	– 4,620 RSF
9th Floor	– 6,370 RSF

- Owner occupied
- Conference Center on site
- Fitness Center, Cycling Room, Concierge 24/7 lobby attendant
- Building Common Area renovation complete – 2018
- Self & valet parking in building
- Across the street from Farragut West and two blocks from Farragut North stations

- Located in the Central Business District
- Within walking distance of numerous high-end restaurants, hotels and banks
- The building has installed a State of the Art air purifying system, Needlepoint Bipolar Ionization which greatly improves indoor air quality and is effective for contaminants both in the air and on surfaces. Study findings conclude that the GPS Needlepoint Bipolar Ionization technology was effective in neutralizing the SARCoV-2 pathogen.

For leasing information, contact

Carla C. Cavanaugh

Vice President, Commercial Leasing

202-617-3122

ccavanaugh@borgermanagement.com

BORGER
MANAGEMENT

5TH FLOOR AVAILABILITY

SUITE 500 9,167 RSF

As-built plan
(Will subdivide)



K STREET

For leasing information, contact
Carla C. Cavanaugh
Vice President, Commercial Leasing
202-617-3122
ccavanaugh@borgermanagement.com




5TH FLOOR AVAILABILITY

SUITE 508

2,647 RSF

As-built plan

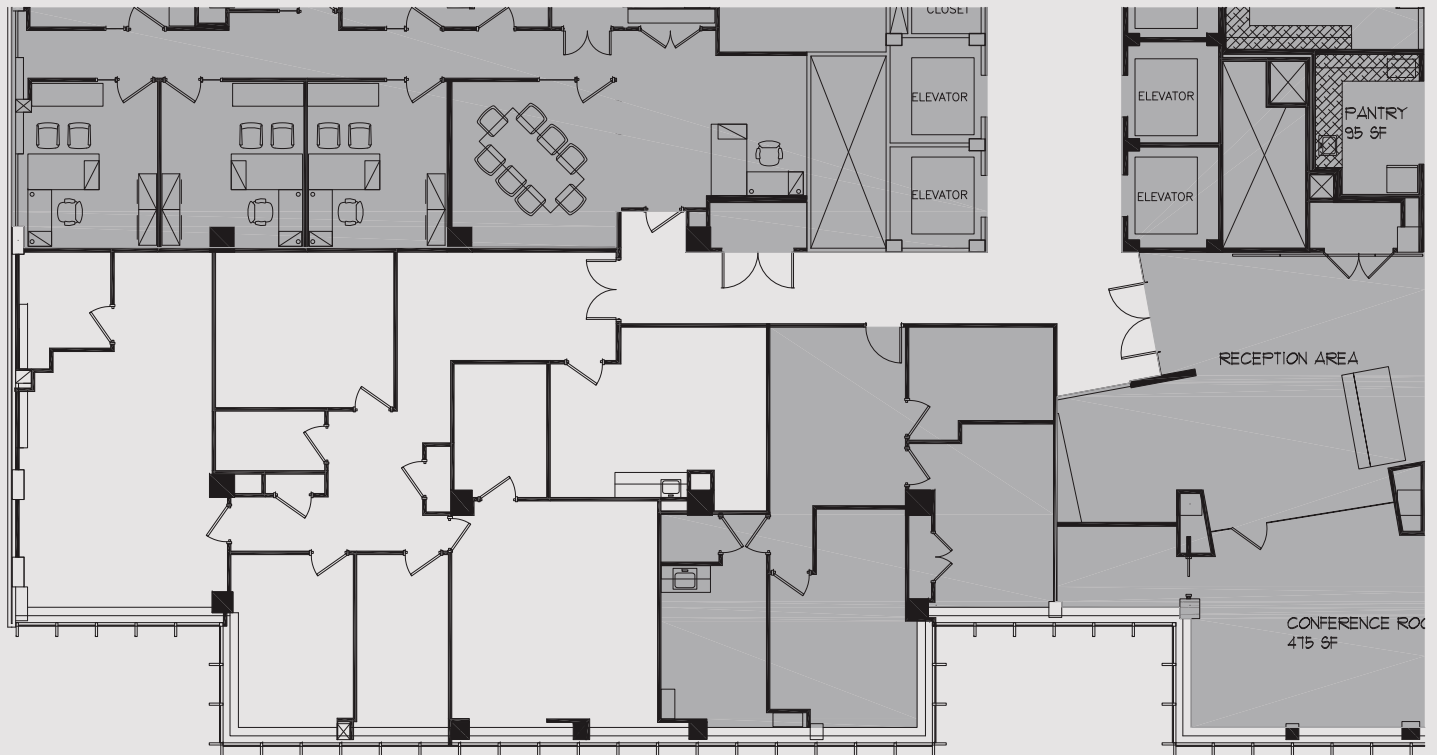

K STREET


For leasing information, contact
Carla C. Cavanaugh
Vice President, Commercial Leasing
202-617-3122
ccavanaugh@borgermanagement.com

BORGER
MANAGEMENT

5TH FLOOR AVAILABILITY

SUITE 510 2,349 RSF

Current plan

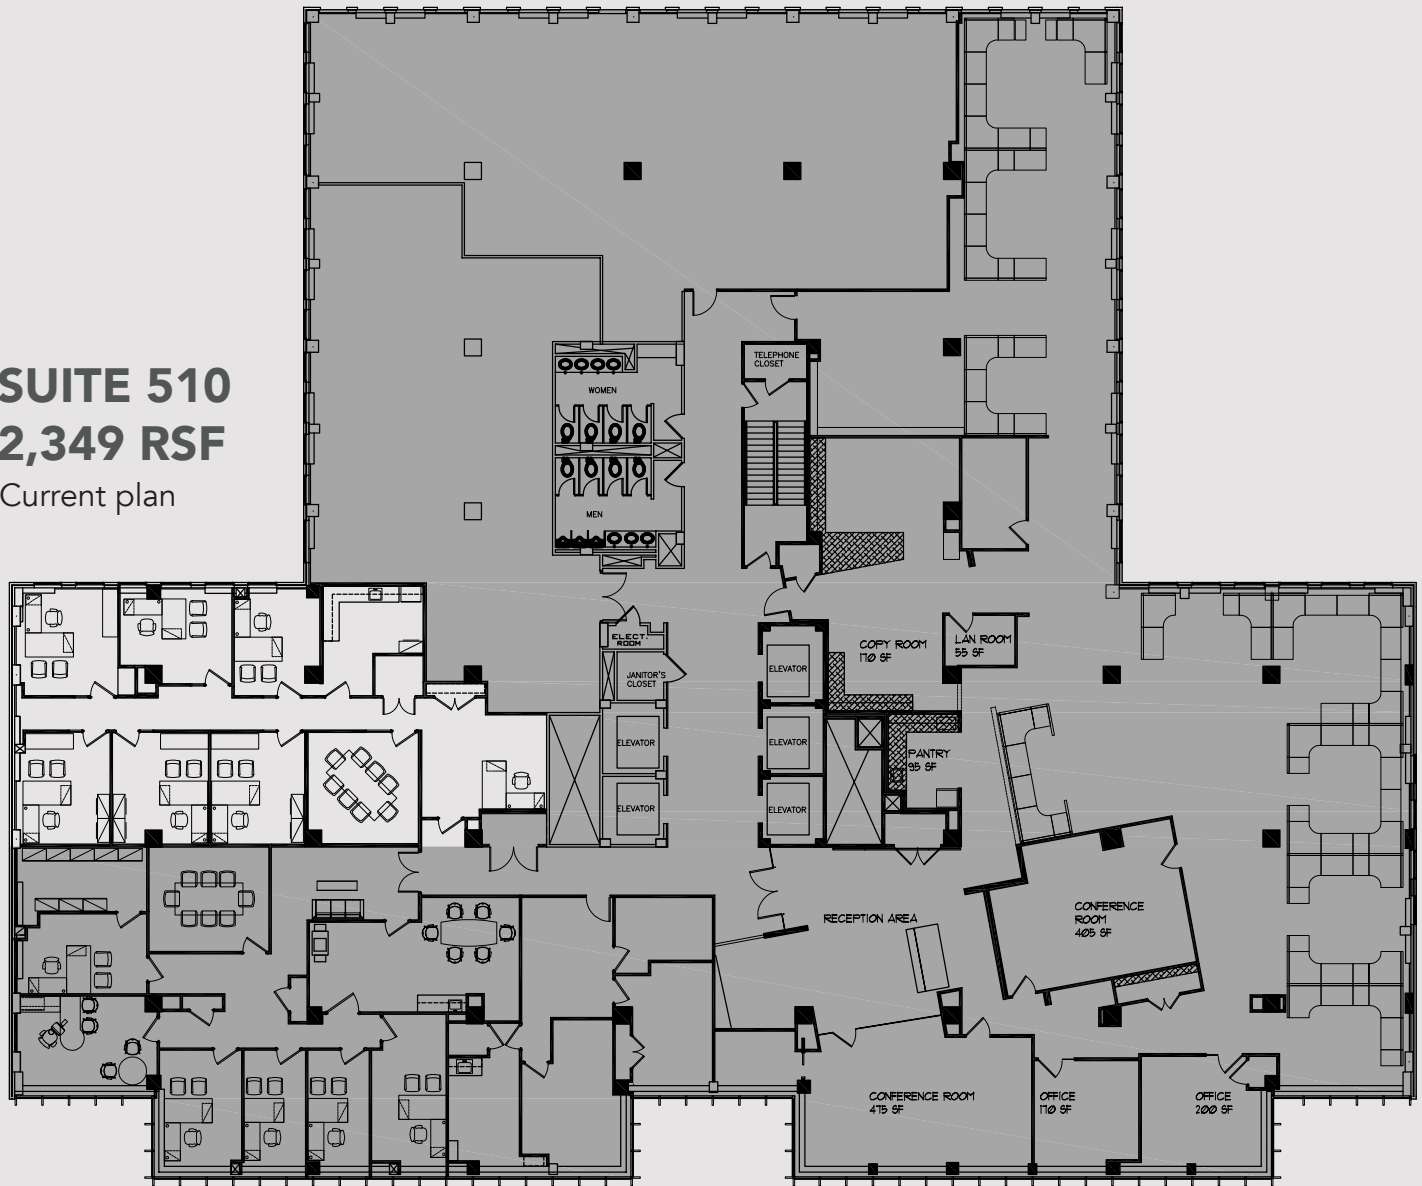

K STREET


For leasing information, contact
Carla C. Cavanaugh
Vice President, Commercial Leasing
202-617-3122
ccavanaugh@borgermanagement.com

BORGER
MANAGEMENT

5TH FLOOR AVAILABILITY

SUITE 515 2,199 RSF

As-built plan

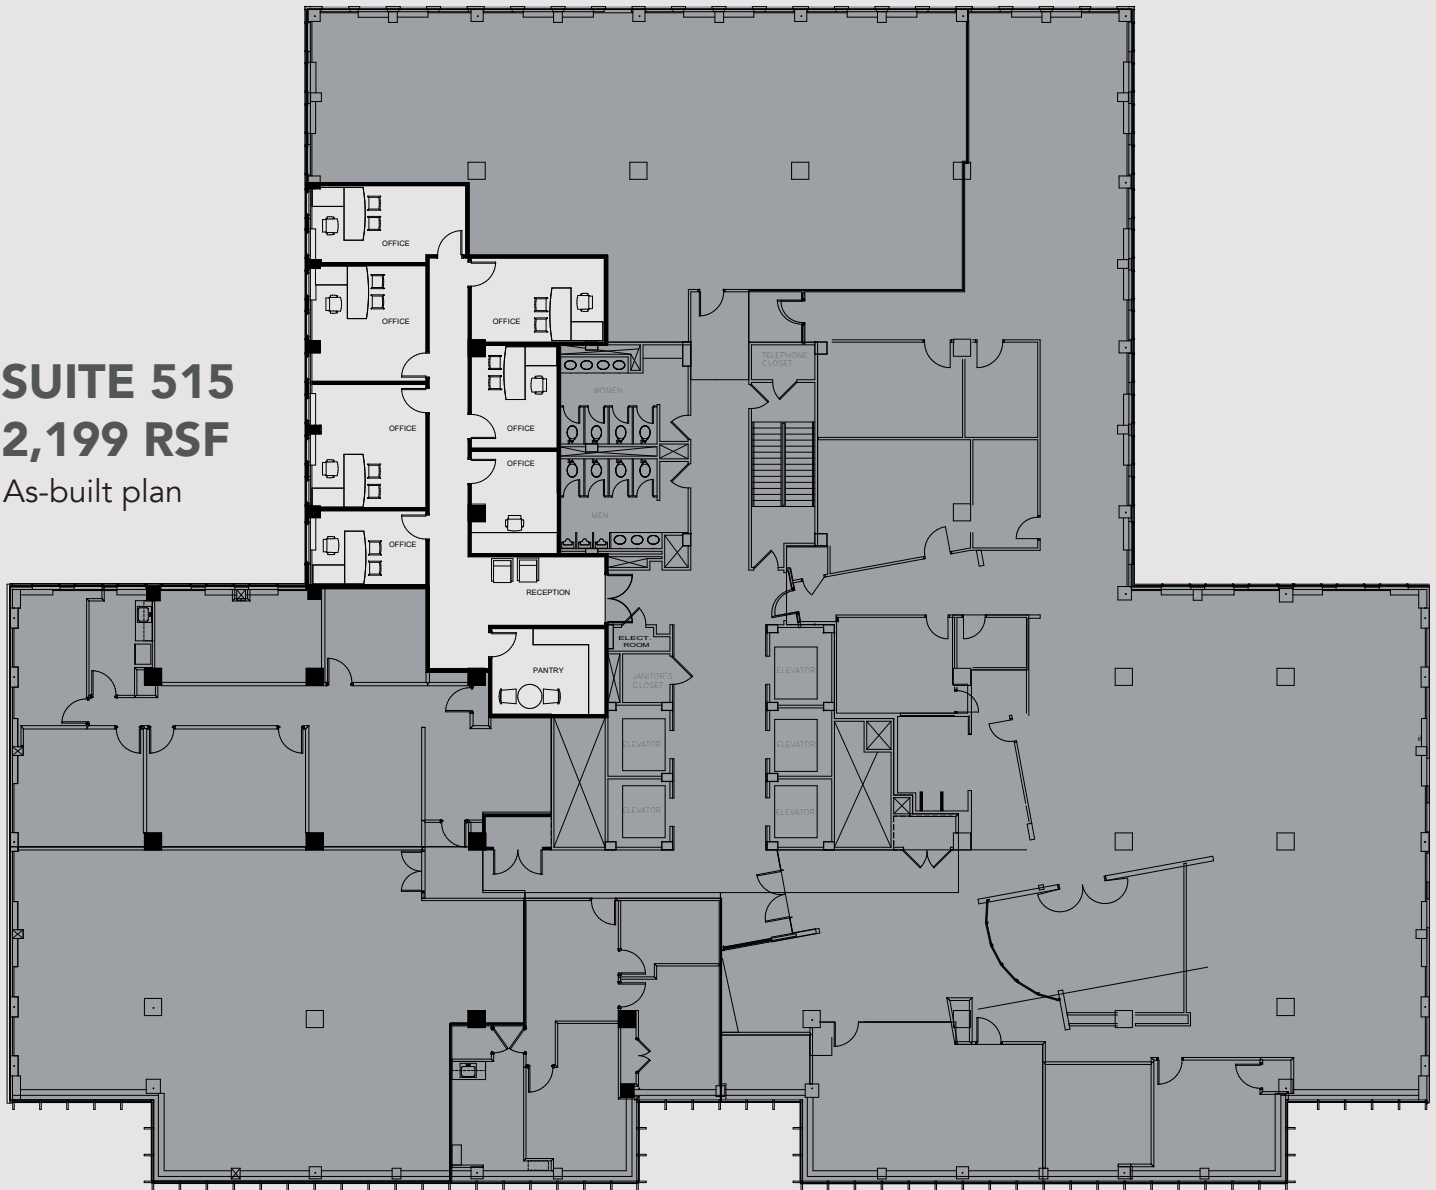

K STREET


For leasing information, contact
Carla C. Cavanaugh
Vice President, Commercial Leasing
202-617-3122
ccavanaugh@borgermanagement.com

BORGER
MANAGEMENT

5TH FLOOR AVAILABILITY

SUITE 600 13,200 RSF

As-buit plan

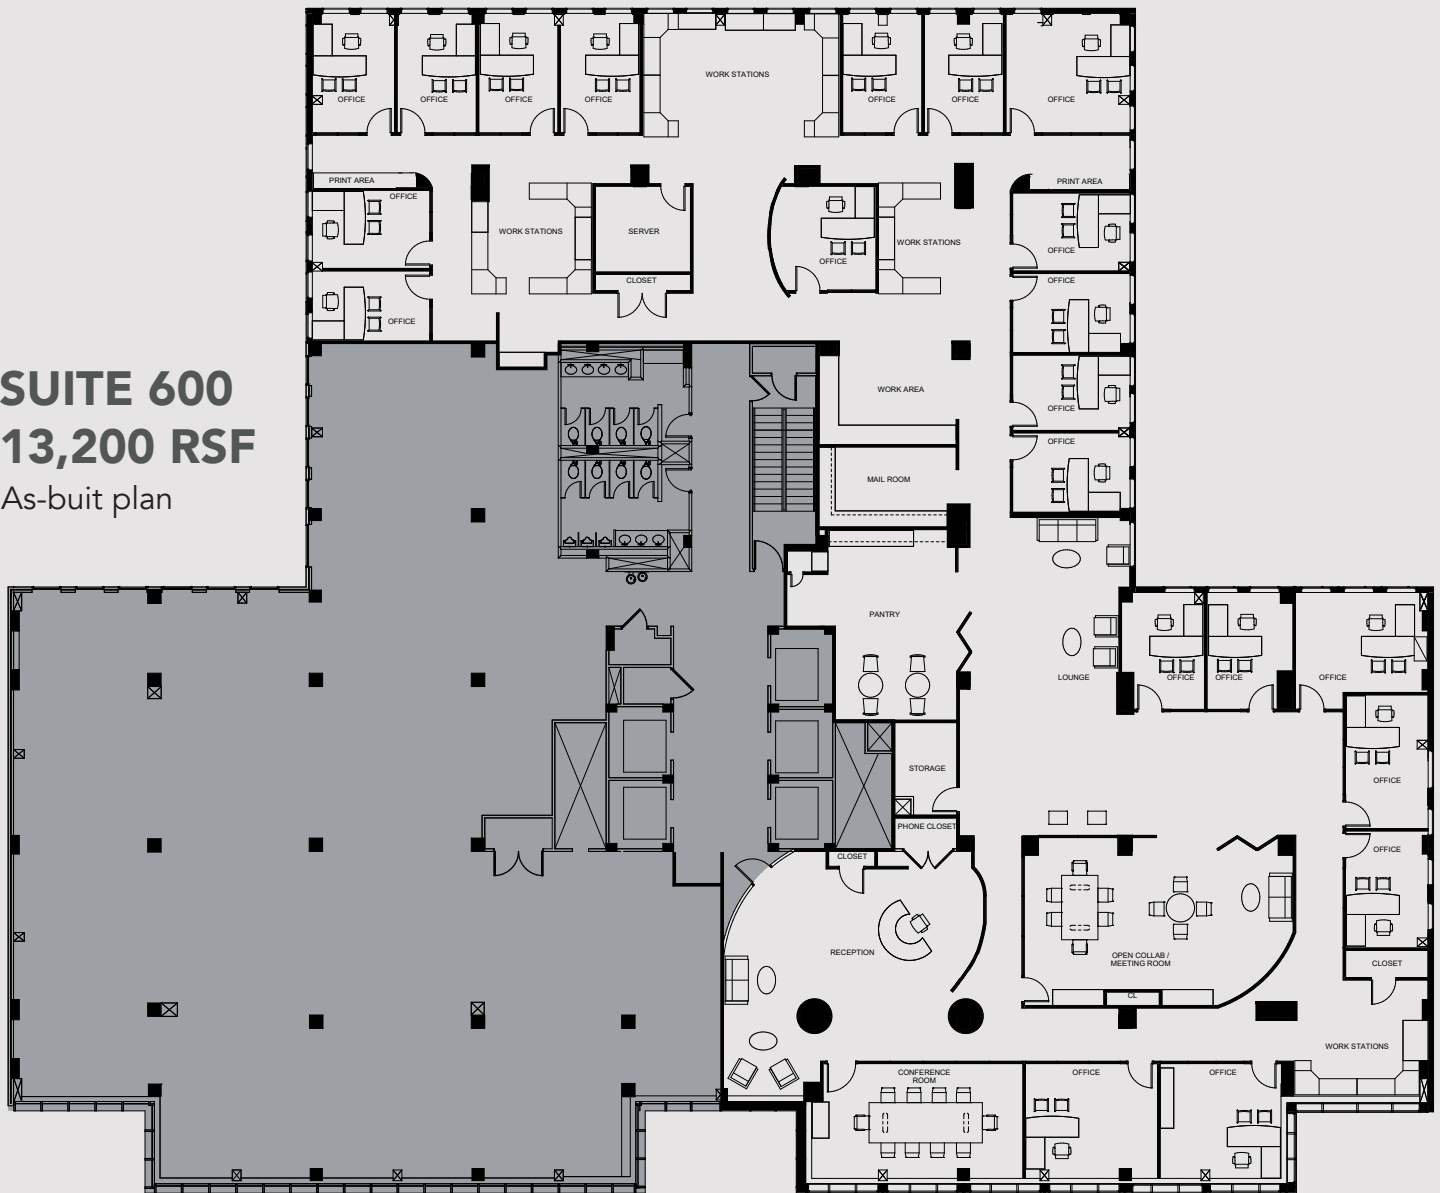

K STREET


For leasing information, contact
Carla C. Cavanaugh
Vice President, Commercial Leasing
202-617-3122
ccavanaugh@borgermanagement.com



7TH FLOOR AVAILABILITY

SUITE 701 1,628 RSF

As-built plan

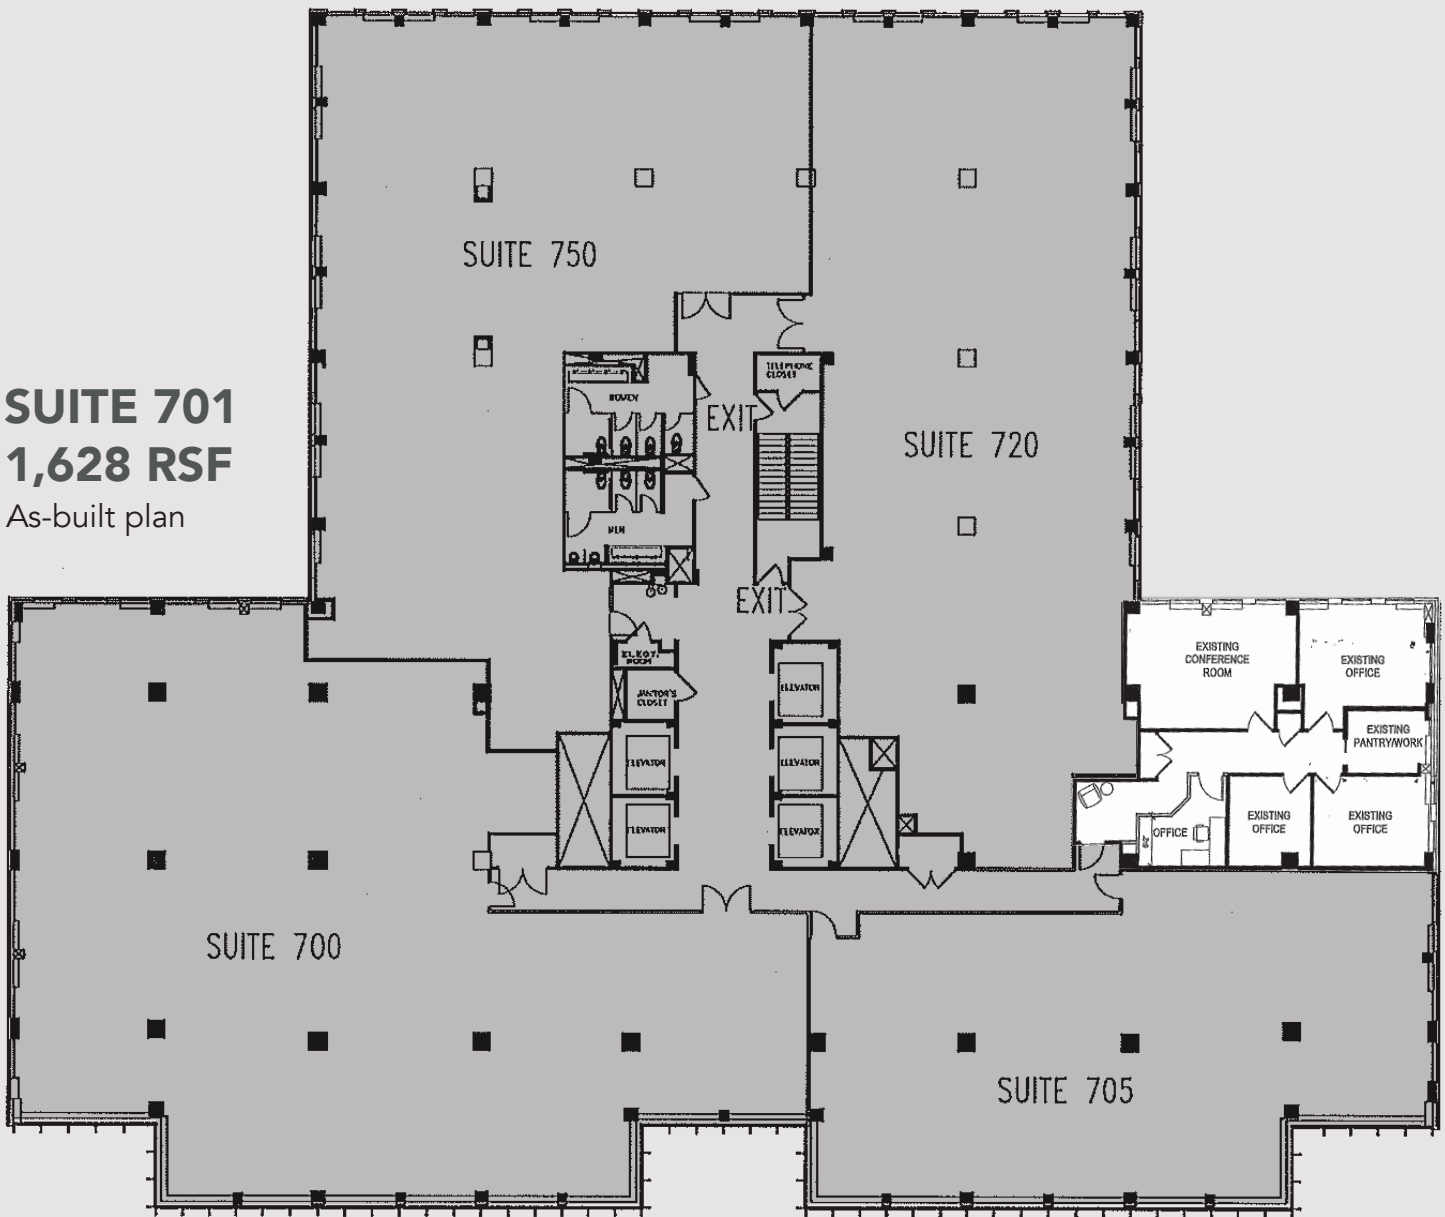

K STREET


For leasing information, contact
Carla C. Cavanaugh
Vice President, Commercial Leasing
202-617-3122
ccavanaugh@borgermanagement.com

BORGER
MANAGEMENT

7TH FLOOR AVAILABILITY

SUITE 720 4,620 RSF

As-built plan

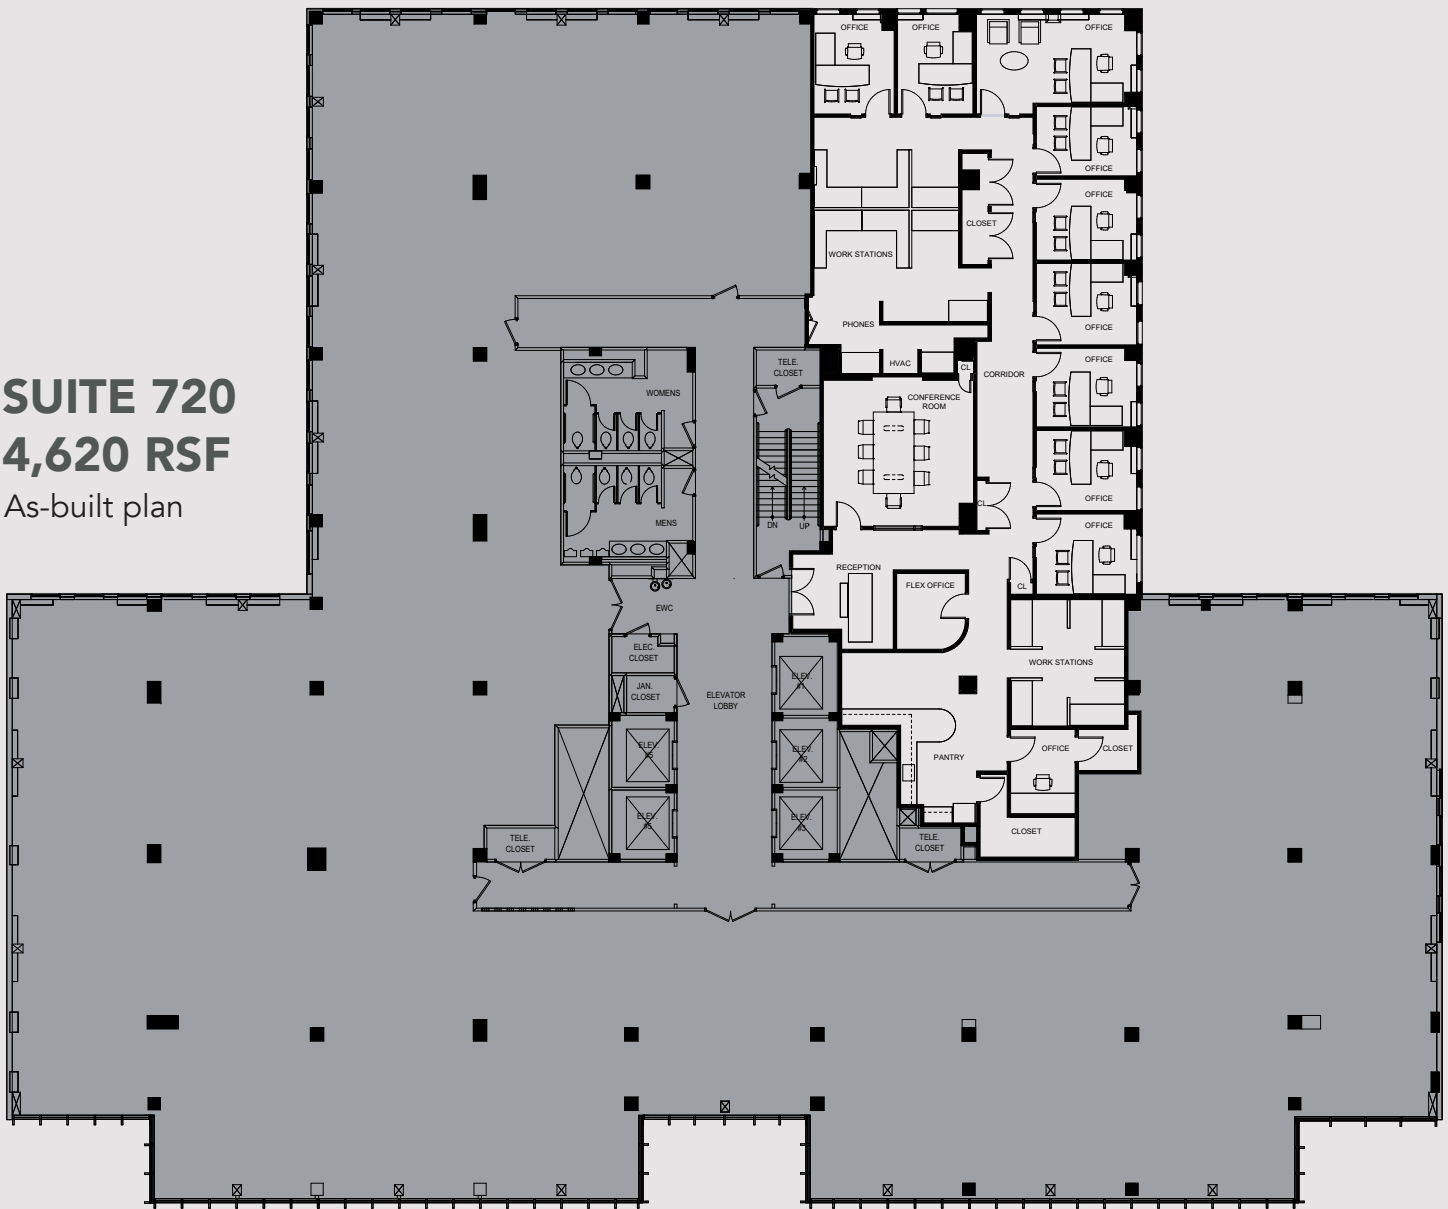

K STREET

For leasing information, contact
Carla C. Cavanaugh
Vice President, Commercial Leasing
202-617-3122
ccavanaugh@borgermanagement.com

BORGER
MANAGEMENT

9TH FLOOR AVAILABILITY

SUITE 900

6,370 RSF

Proposed plan




K STREET

For leasing information, contact
Carla C. Cavanaugh
Vice President, Commercial Leasing
202-617-3122
ccavanaugh@borgermanagement.com

BORGER
MANAGEMENT

LOCATION & AMENITIES

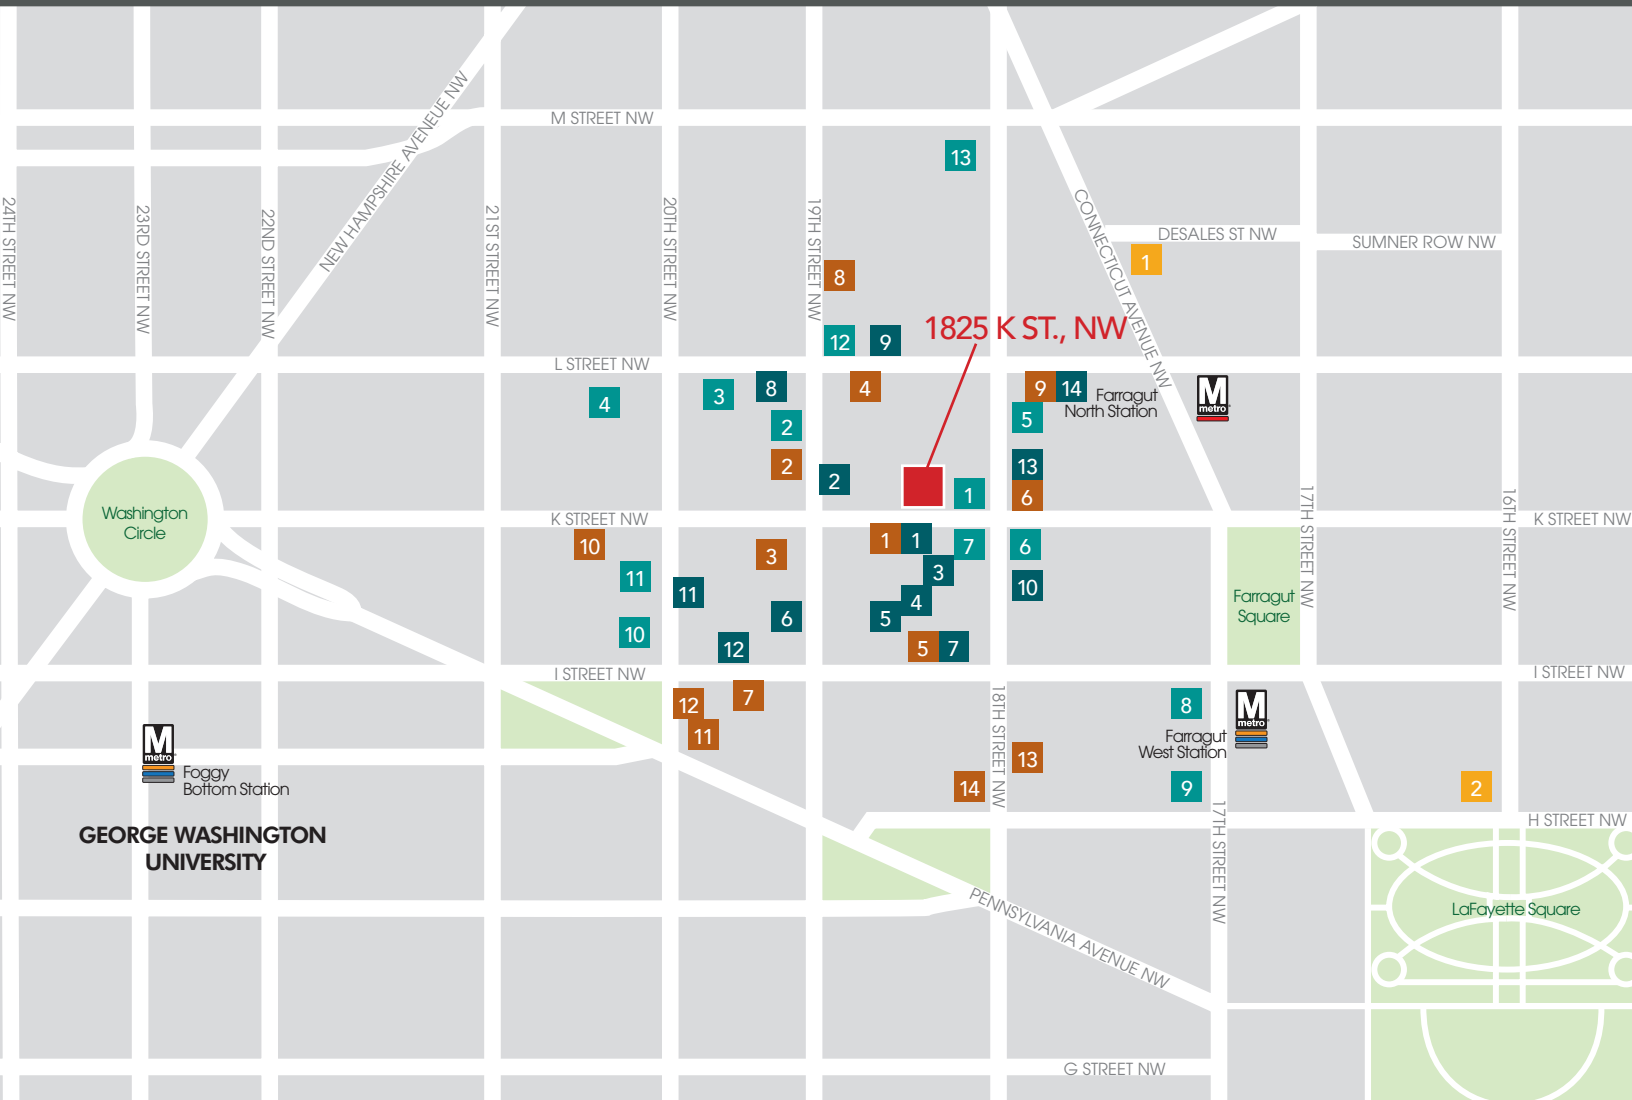

RESTAURANTS

1. Sichuan Pavilion
2. Protein Bar
3. Rasoi Indian Kitchen
4. Five Guys Burgers and Fries
5. Cities Restaurant & Lounge
6. Elephant & Castle
7. Stoupsy's
8. Potbelly Sandwich Shop
9. Pret A Manger
10. Devon & Blakely
11. Washington Deli
12. KAZ Sushi Bistro
13. Jack's Fresh
14. Au Bon Pain

COFFEE

1. Au Bon Pain
2. Cafe Carvy
3. Starbucks
4. Corner Bakery Cafe
5. Havana Cafe
6. Cafe' Grande
7. Filter Coffeehouse & Espresso
8. Dunkin' Donuts
9. Starbucks
10. K Street Cafe & Bagel
11. Greenberry's Coffee & Tea
12. Penn Grill
13. Starbucks
14. Corner Bakery Cafe

BANKS

1. Bank of America Financial Center
2. Sun Trust Bank
3. PNC Bank
4. Wells Fargo Bank
5. PNC Bank
6. Cardinal Bank
7. Wells Fargo Bank
8. Bank of America Financial Center
9. PNC Bank
10. State Bank of India
11. TD Bank
12. M&T Bank
13. Capital One Bank

HOTELS

1. The Mayflower Hotel
2. The Hay-Adams

For leasing information, contact

Carla C. Cavanaugh

Vice President, Commercial Leasing

202-617-3122

ccavanaugh@borgermanagement.com



THE INFORMATION CONTAINED HEREIN IS BELIEVED TO BE ACCURATE BUT THE LANDLORD OR AGENT DOES NOT WARRANT OR GUARANTY THE ACCURACY AND THEREFORE IS SUBJECT TO CHANGE WITHOUT NOTICE.